


Index

26.14
26.10 26.11 26.12
26.02

Legend

- 150mm CL 150 A.C. WATERMAIN c/w SIZE CLASS & MATERIAL
- DOUBLE 19mm DOMESTIC SERVICE DISTANCE IN METERS
 - 19mm DOMESTIC SERVICE
 - 25mm IRRIGATION SERVICE
 - 38mm IRRIGATION SERVICE
 - 50mm IRRIGATION SERVICE
 - 65mm IRRIGATION SERVICE
 - 75mm IRRIGATION SERVICE
 - GATE VALVE
 - P.R.V. VALVE STATION
 - BOOSTER PUMP STATION
 - 150/100 WATERLINE REDUCER (mm)
 - HYDRANT
 - AIR VALVE
 - BLOW OFF
 - CAP
 - PROPERTY LINE OFFSET (m)
 - IRON PIN

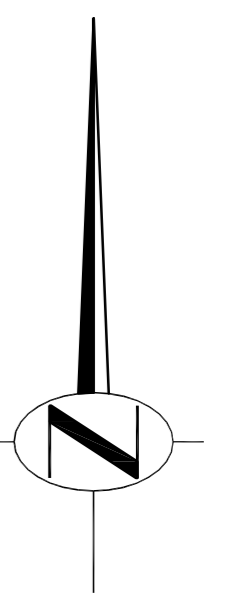

Scale: 1:2,500

Date: December 31, 2003

Drawn: J.S.Degner

1"=100' AS-BUILT MAPS

- 68
- 75
- 76

Notes:

Any services without dimensions are located at the center of the property.

For the sake of clarity hydrants are shown without valves.

2 DWG. UPDATE	MARCH, 2006
1 TO METRIC	APRIL, 2005

Revisions

Date: March 2006

Number:

This plan is not a legal document and is for general information only.

