


| |
|-------------|
| 27.18 |
| 26.12 27.07 |
| 27.06 |

Legend

- 150mm CL 150 A.C. WATERMAIN c/w SIZE CLASS & MATERIAL
- DOUBLE 19mm DOMESTIC SERVICE DISTANCE IN METERS
- 19mm DOMESTIC SERVICE
- 25mm IRRIGATION SERVICE
- 38mm IRRIGATION SERVICE
- 50mm IRRIGATION SERVICE
- 65mm IRRIGATION SERVICE
- 75mm IRRIGATION SERVICE
- GATE VALVE
- P.R.V. VALVE STATION
- BOOSTER PUMP STATION
- 150/100 WATERLINE REDUCER (mm)
- HYDRANT
- AIR VALVE
- BLOW OFF
- CAP
- PROPERTY LINE OFFSET (m)
- IRON PIN

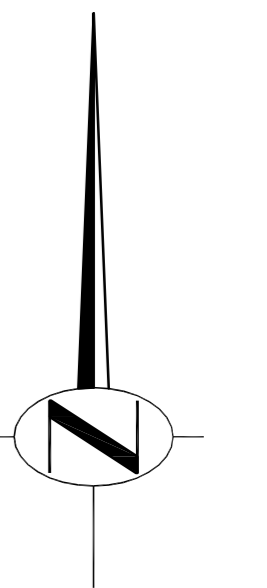

Scale: 1:2,500

Date: January 9, 2004

Drawn: J.S.Degner

1"=100' AS-BUILT MAPS

- 61A 63
- 62 63A
- 0235-10

Notes:

Any services without dimensions are located at the center of the property.

For the sake of clarity hydrants are shown without valves.


| | |
|---------------|-------------|
| 2 DWG. UPDATE | MARCH, 2006 |
| 1 TO METRIC | APRIL, 2005 |

Revisions

Date: March 2006

Number:

This plan is not a legal document and is for general information only.

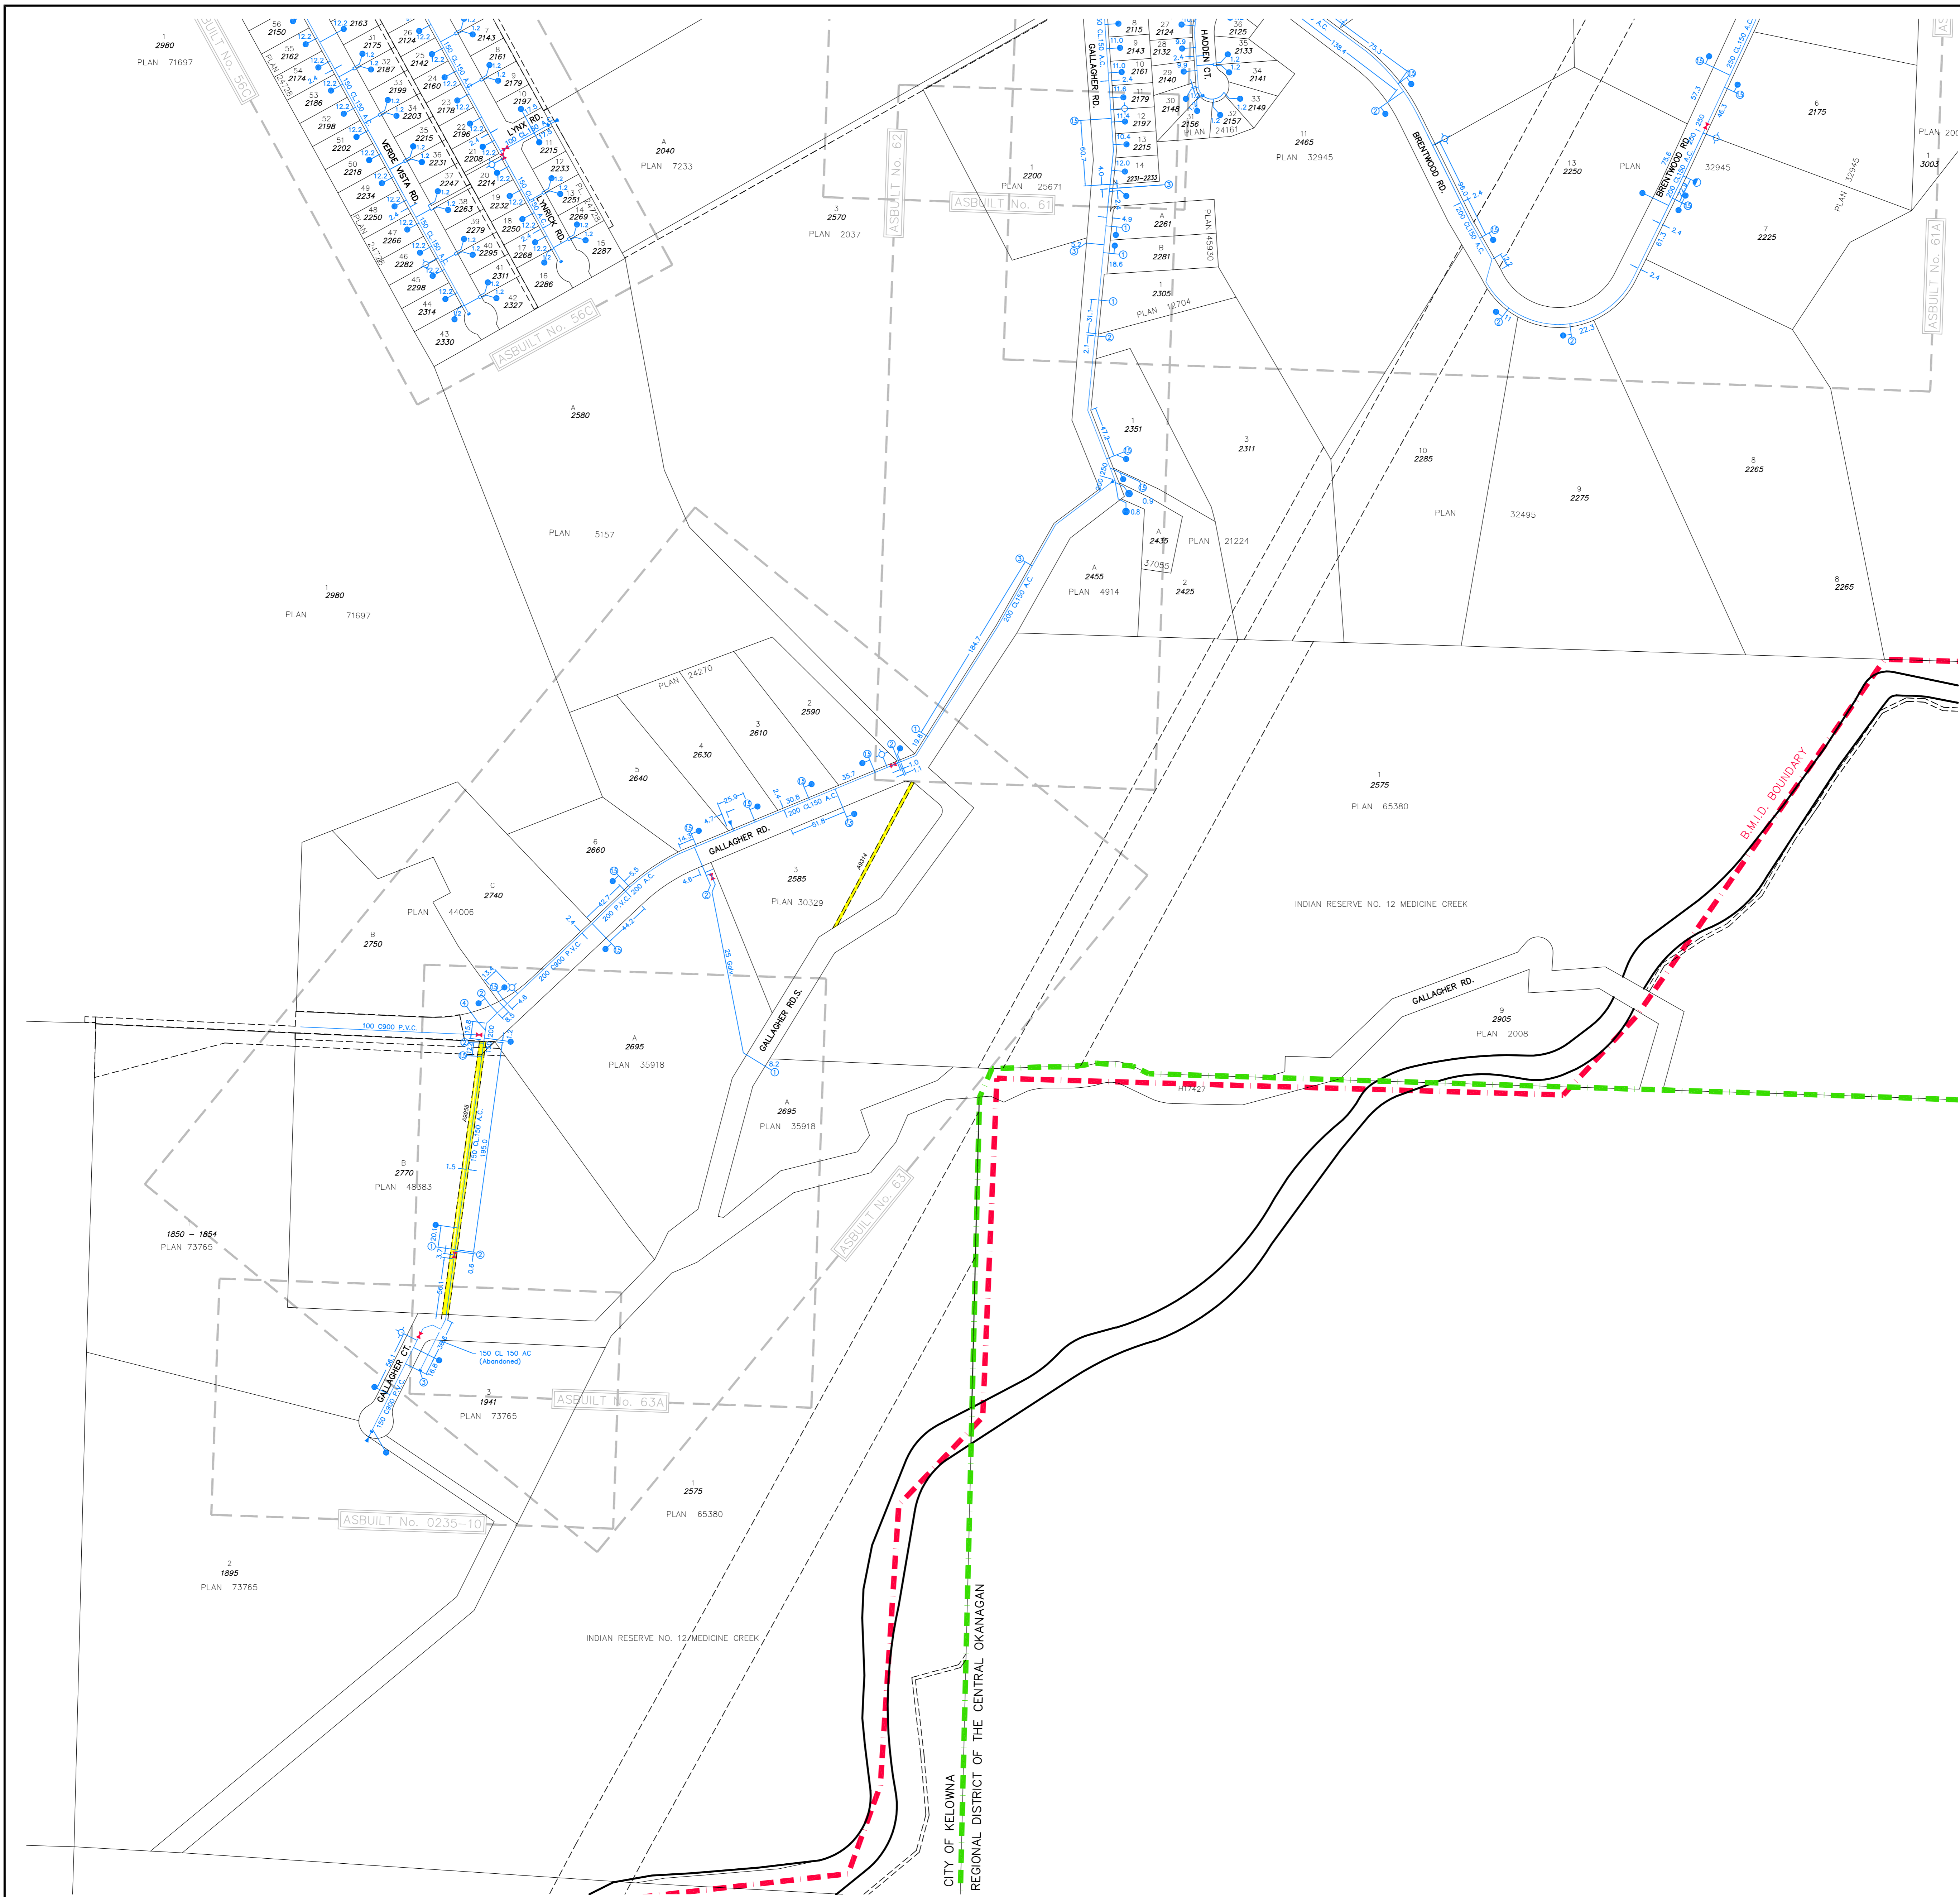

CITY OF KELOWNA
 REGIONAL DISTRICT OF THE CENTRAL OKANAGAN