


Index

	27.17	
27.07	27.08	

Legend

150mm CL 150 A.C.	WATERMAIN c/w SIZE CLASS & MATERIAL
	DOUBLE 19mm DOMESTIC SERVICE DISTANCE IN METERS
	19mm DOMESTIC SERVICE
	25mm IRRIGATION SERVICE
	38mm IRRIGATION SERVICE
	50mm IRRIGATION SERVICE
	65mm IRRIGATION SERVICE
	75mm IRRIGATION SERVICE
	GATE VALVE
	P.R.V. VALVE STATION
	Booster Pump Station
	Booster Pump Station
	Waterline Reducer (mm)
	HYDRANT
	AIR VALVE
	BLOW OFF
	CAP
	PROPERTY LINE OFFSET (m)
	IRON PIN

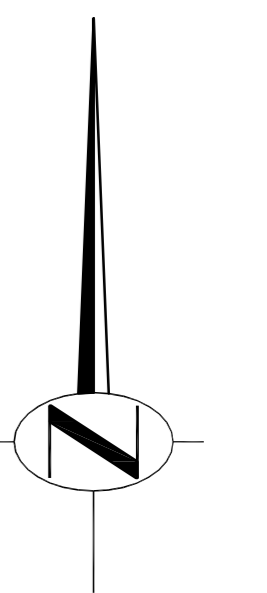

Scale: 1:2,500

Date: July 22, 2003

Drawn: J.S. Degner

1"=100' AS-BUILT MAPS

Notes:

Any services without dimensions are located at the center of the property.

For the sake of clarity hydrants are shown without valves.

2 DWG. UPDATE	MARCH, 2006
1 TO METRIC	APRIL, 2005

Revisions

Date: March 2006

Number:

This plan is not a legal document and is for general information only.

