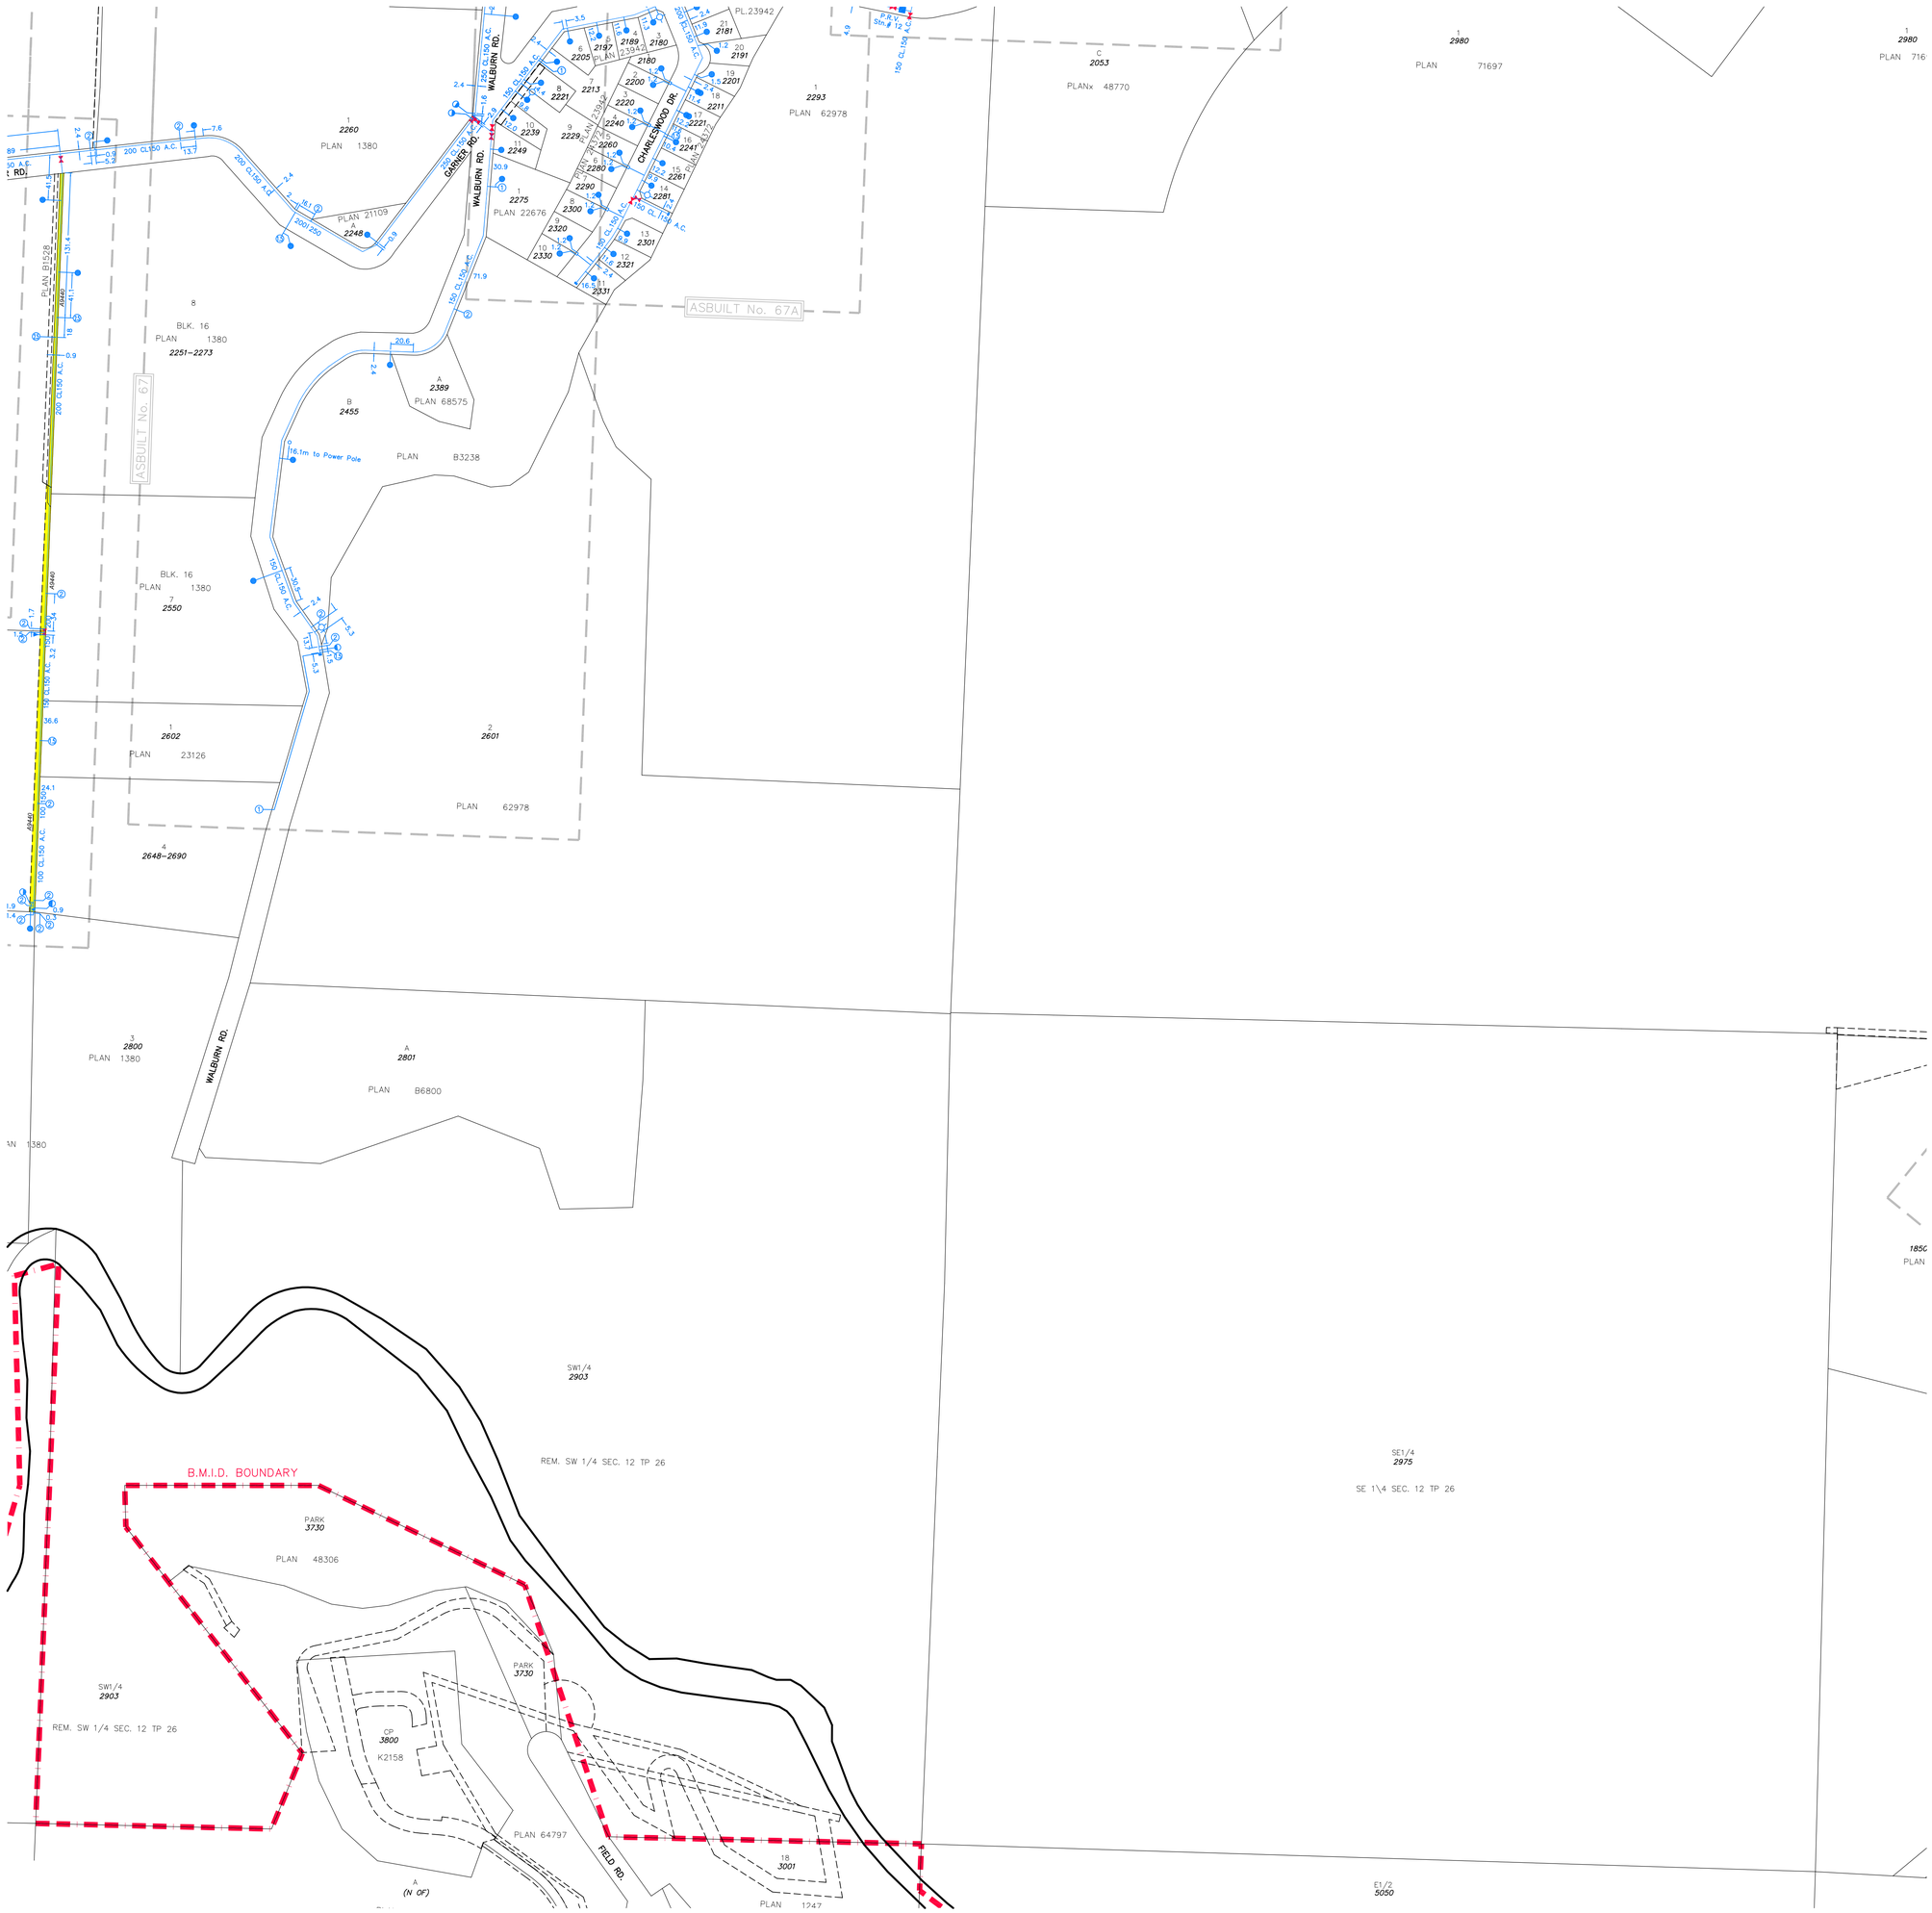

Legal Composite Map No.

26.12

Index

	26.13	
26.11	26.12	27.07
	26.01	

Legend

150mm CL.150 A.C.	WATERMAIN c/w SIZE, CLASS & MATERIAL
4 4	DOUBLE 19mm DOMESTIC SERVICE DISTANCE IN METERS
	19mm DOMESTIC SERVICE
1	25mm IRRIGATION SERVICE
1½	38mm IRRIGATION SERVICE
2	50mm IRRIGATION SERVICE
2½	65mm IRRIGATION SERVICE
3	75mm IRRIGATION SERVICE
	GATE VALVE
P.R.V. Stn.#	PRESURE REDUCING VALVE STATION
B.P. Stn.#	BOOSTER PUMP STATION
150 100	WATERLINE REDUCER (mm)
	HYDRANT
	AIR VALVE
	BLOW OFF
	CAP
2.4	PROPERTY LINE OFFSET (m)
	IRON PIN

Scale: 1:2,500

Date: July 22,2003

Drawn: J.S.Degner

1"=100' AS-BUILT MAPS

67
67A

Notes:

Any services without dimensions are located at the center of the property.

For the sake of clarity hydrants are shown without valves.

2	DWG. UPDATE	MARCH, 2006
1	TO METRIC	APRIL, 2005

Revisions

Date: March 2006

Number:

This plan is not a legal document and is for general information only.