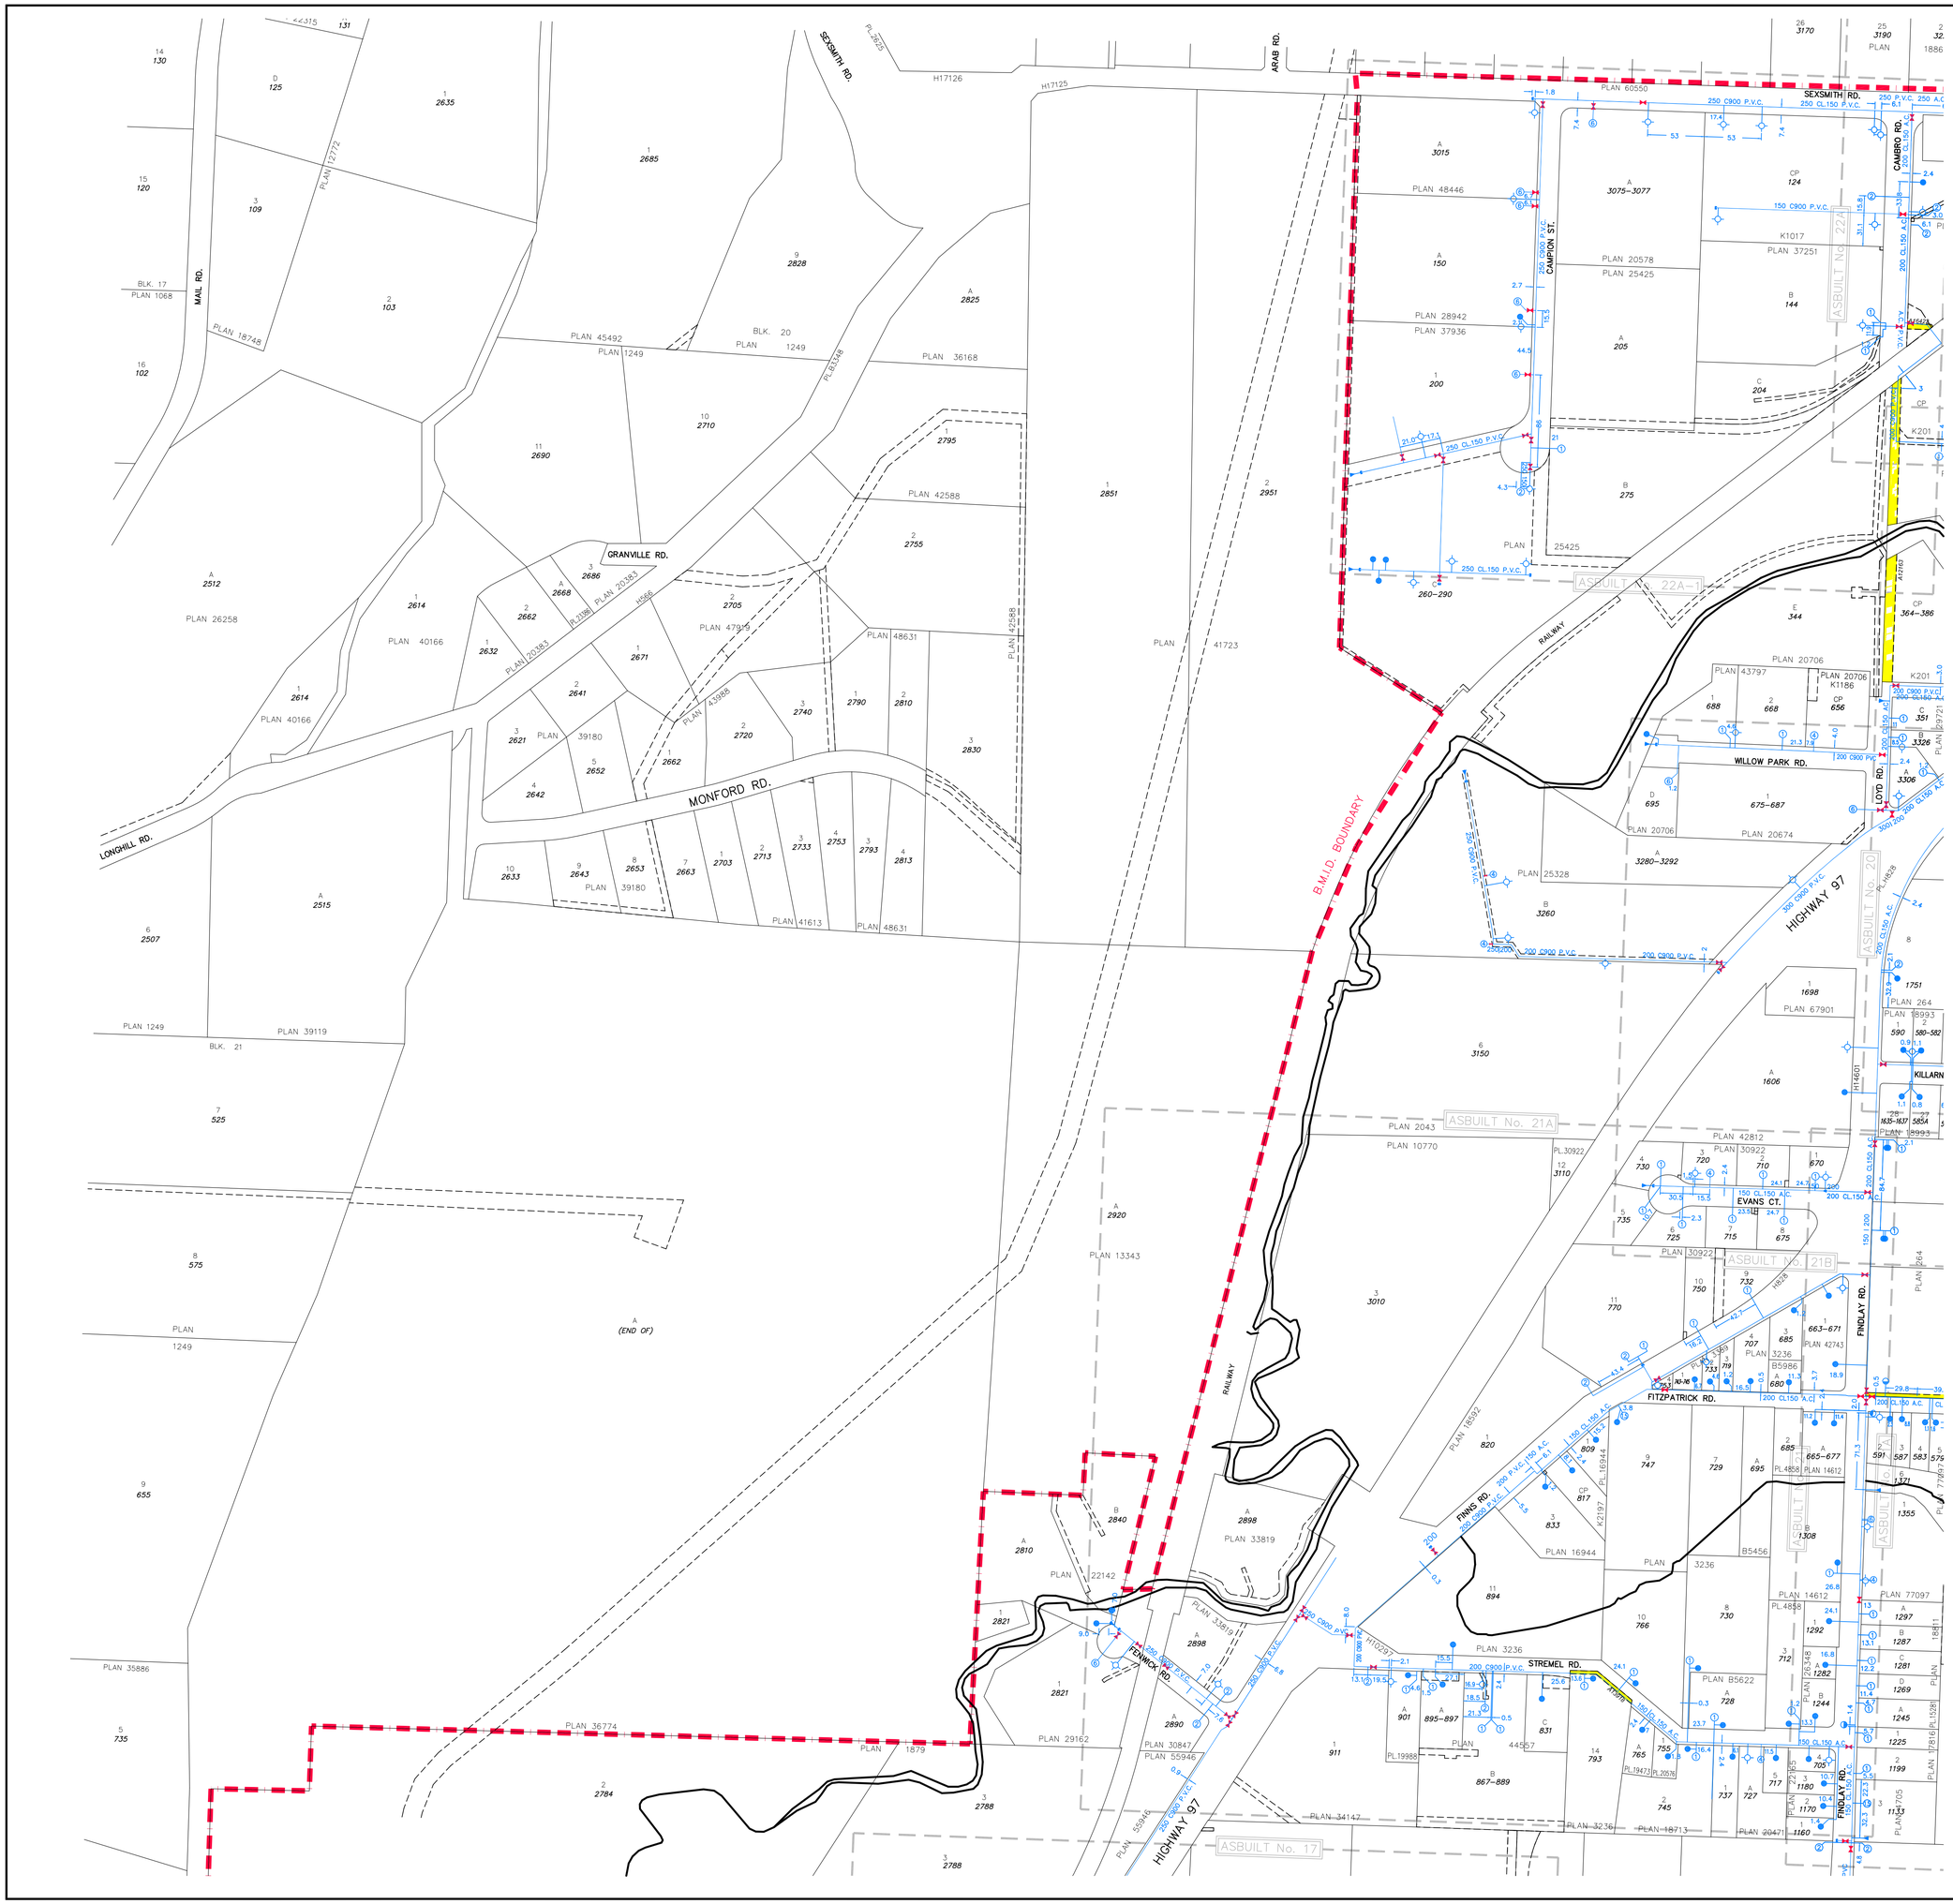

Legal Composite Map No.

26.34

Index

	23.03	
26.33	26.34	26.35
	26.27	

Legend

150mm CL.150 A.C.	WATERMAIN c/w SIZE, CLASS & MATERIAL
	DOUBLE 19mm DOMESTIC SERVICE DISTANCE IN METERS
	19mm DOMESTIC SERVICE
1	25mm IRRIGATION SERVICE
1½	38mm IRRIGATION SERVICE
2	50mm IRRIGATION SERVICE
2½	65mm IRRIGATION SERVICE
3	75mm IRRIGATION SERVICE
	GATE VALVE
P.R.V. Stn.#	PRESURE REDUCING VALVE STATION
B.P. Stn.#	BOOSTER PUMP STATION
150 | 100	WATERLINE REDUCER (mm)
	HYDRANT
	AIR VALVE
	BLOW OFF
	CAP
2.4	PROPERTY LINE OFFSET (m)
	IRON PIN

Scale: 1:2,500

Date: July 9,2003

Drawn: J.S.Degner

1"=100' AS-BUILT MAPS

20	21B
21	22A
21A	22A-1

Notes:

Any services without dimensions are located at the center of the property.

For the sake of clarity hydrants are shown without valves.

2	DWG. UPDATE	MARCH, 2006
1	TO METRIC	APRIL, 2005

Revisions

Date: March 2006

Number:

This plan is not a legal document and is for general information only.